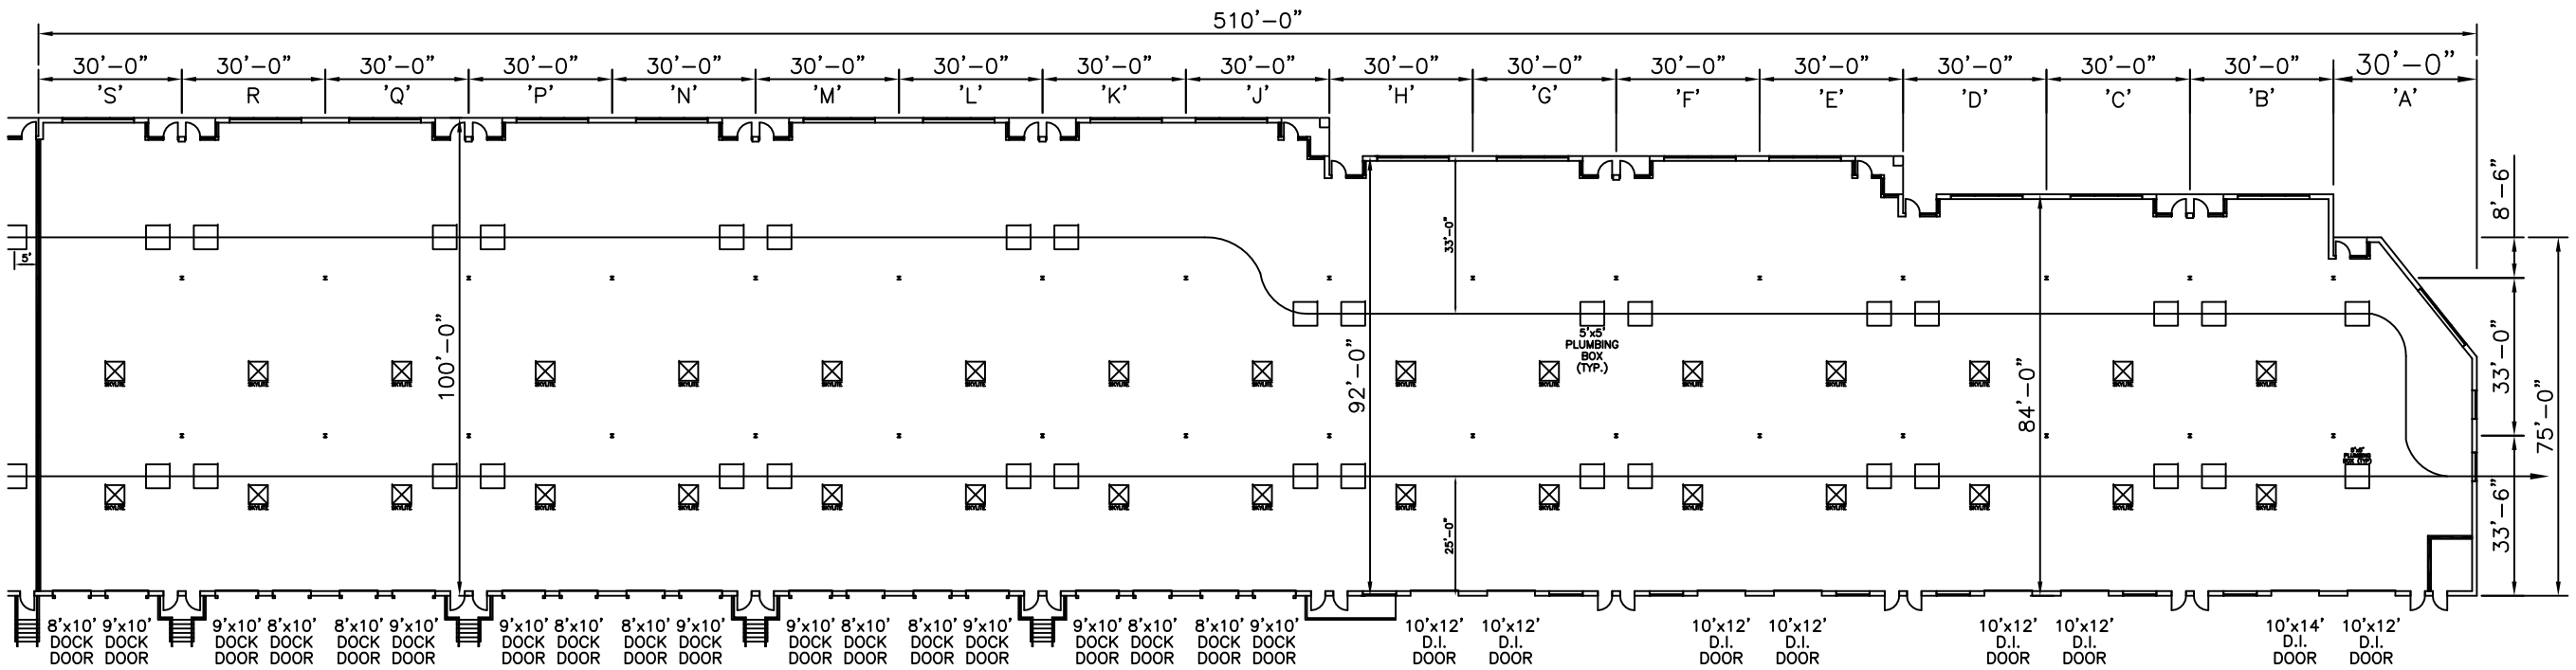

SCALE: NOT TO SCALE DRAWN: CET DATE: 5/4/2010 CADFILE: 5119Peg.Bldg_H_Asbuilts.dwg REVISIONS: 5/14/2010	5119 PEGASUS COURT SUITES 'A-S' CENTER AT MONOCACY FREDERICK, MD 21704	ST.JOHN PROPERTIES ST.JOHN PROPERTIES, INC. 5104 PEGASUS COURT, ST. A FREDERICK, MD 21704 OFFICE: 301-662-9215 FAX: 301-682-9217	SHELL PLAN TOTAL: 47,600 SQ.FT.	DRAWING NO. 1 OF 1