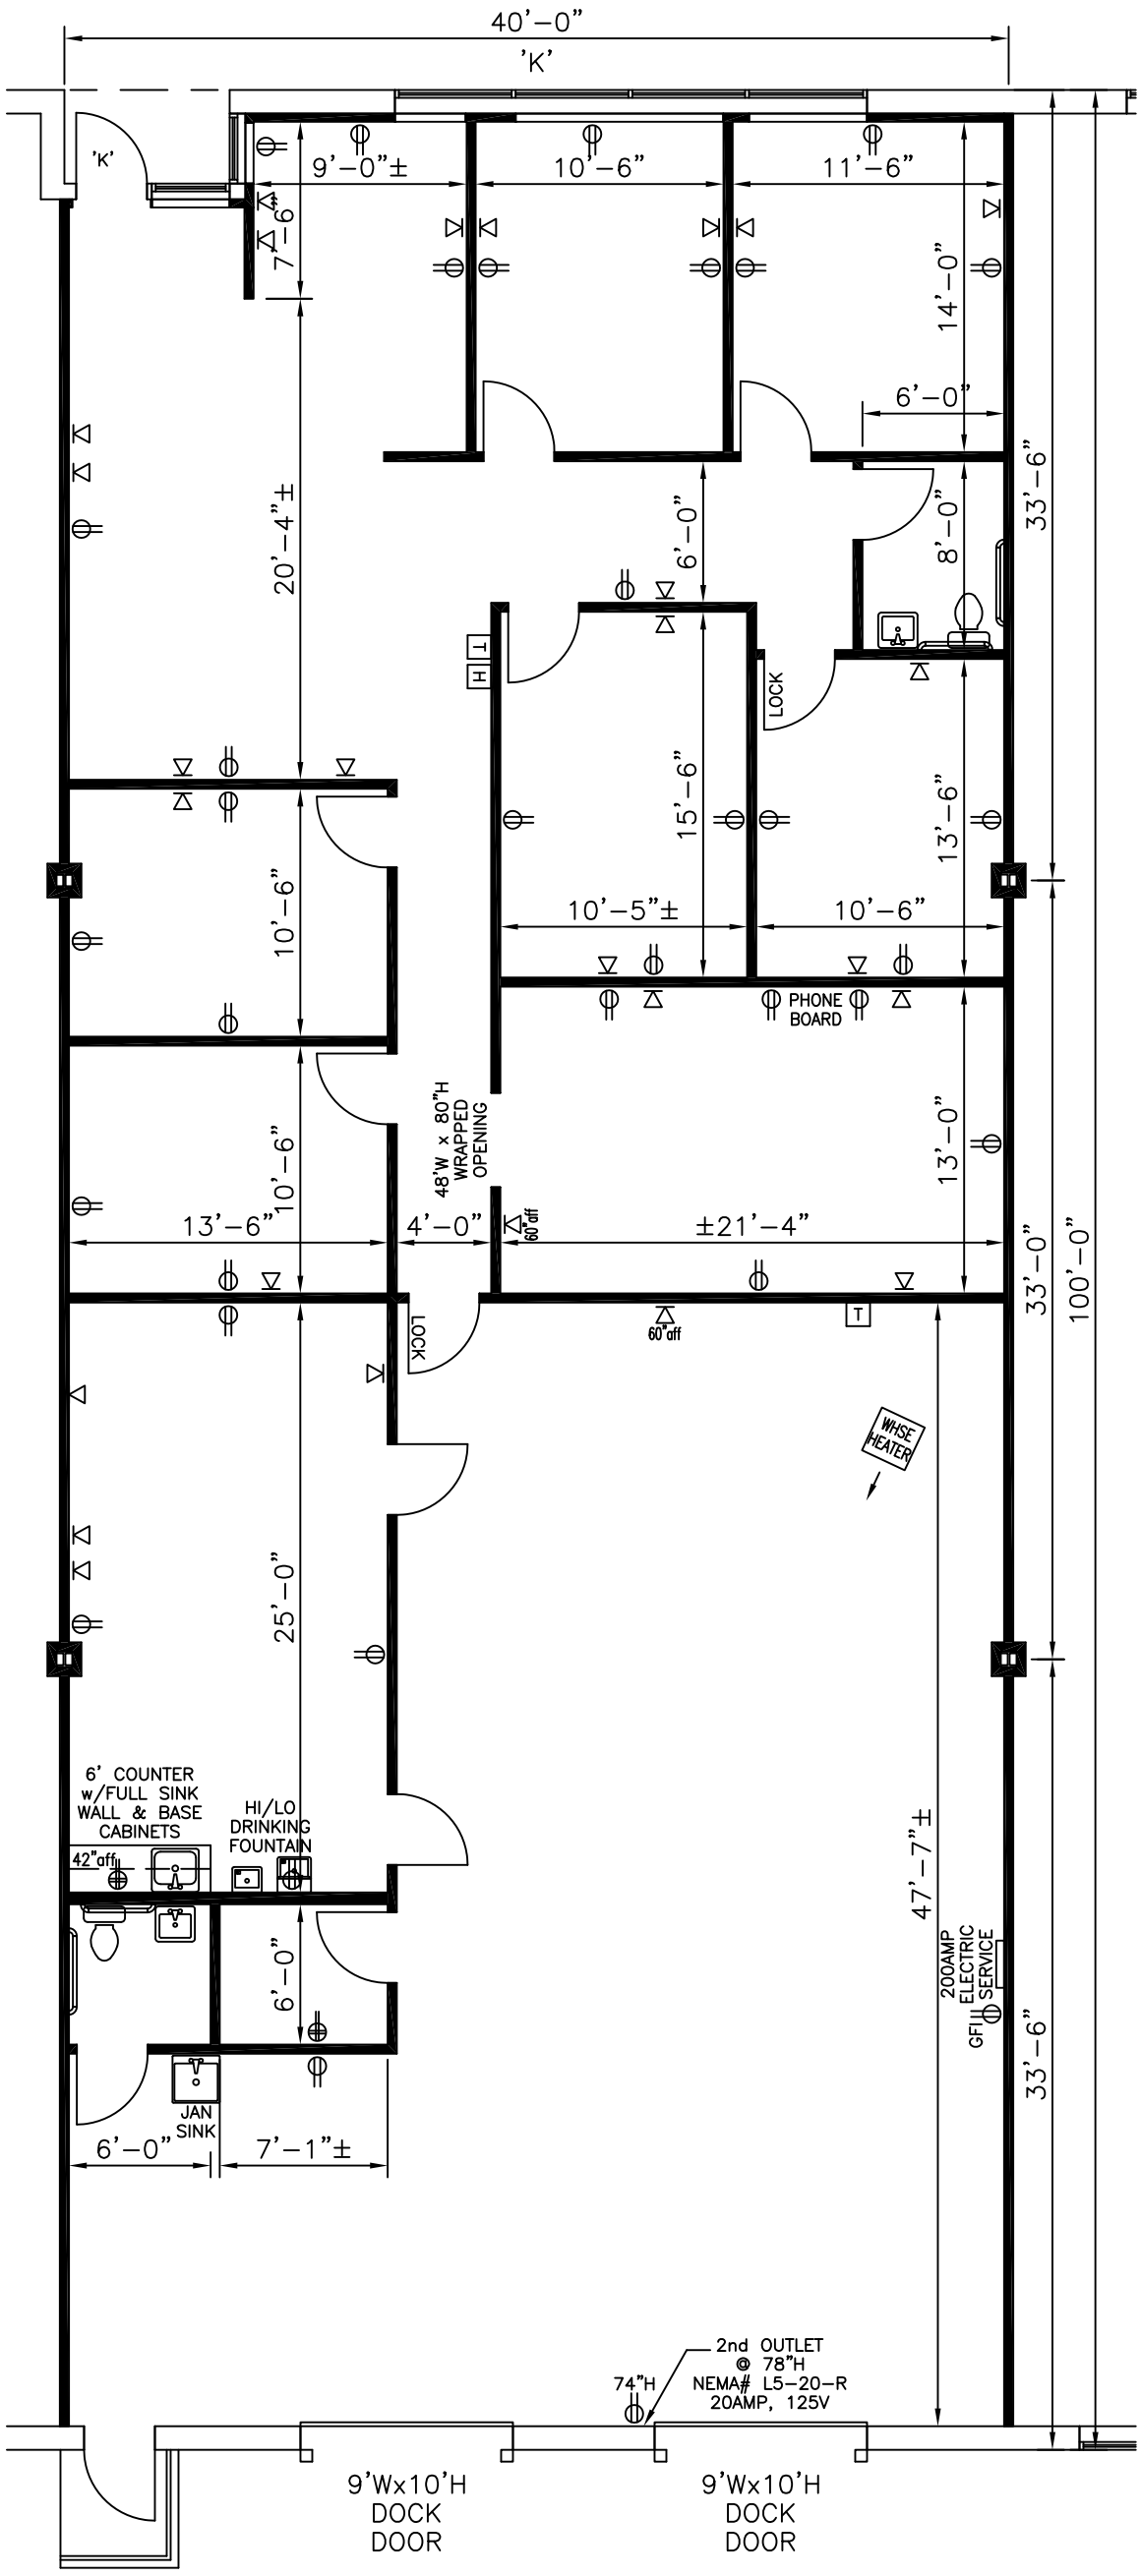

SCALE: 1/8"=1'-0" DRAWN: CET DATE: 12/3/09 CADFILE: 5103.D.Asbuilt.dwg REVISIONS: 9/9/10	5103 PEGASUS CT. SUITE 'K' CENTER AT MONOCACY FREDERICK, MD 21704	ST.JOHN PROPERTIES ST. JOHN PROPERTIES, INC. 5104 PEGASUS COURT SUITE 'A' FREDERICK, MD 21704 OFFICE: 301-682-9215 FAX: 301-682-9217	FLOOR PLAN TOTAL: 4,000 SQ. FT. OFFICE: 2,490 SQ. FT. WHSE: 1,510 SQ. FT.	DRAWING NO. 1 OF 1